NOTICE OF PUBLIC HEARING
ST. ALBANS CITY COUNCIL
MONDAY, APRIL 13, 2015
6:30 PM
ST. ALBANS CITY HALL
100 NORTH MAIN STREET, ST. ALBANS, VT

The St. Albans City Council will hold a public hearing and second reading of a revision to the City Ordinance governing Operation of Vehicles and Timed Parking Zones, Title 17, Section 5351. After the hearing is closed, the Council may vote on adoption of the revision.

Effects of the Proposed Ordinance Revision:
This revision will designate two on-street parking spaces on the west side of North Main Street, near 36-38 North Main Street and just north of the mid-block crosswalk, as 30 minute parking only, 9am-6pm Monday-Saturday. The purpose of this revision is to increase customer turn-over for those two spaces for the benefit of proximate businesses.

Full texts of these proposed revisions may be viewed at the St. Albans City Clerk's Office, St. Albans City Hall, 100 North Main Street.

If special accommodations are required, please contact Chip Sawyer at 802-524-1500 x259 or c.sawyer@stalbansvt.com. For the hearing impaired please call (TTY) # 1-800-253-0191.

The Council of the City of St. Albans hereby ordains...

(Second Reading)

An Amendment to the current Ordinance governing Operation of Vehicles and Timed Parking Zones, Title 17, Chapter 5, Sub-Chapter 6.

Text to be added is underlined and text to be deleted is ~~struck out~~.

Whereas, The UPS Store at 38 North Main Street requires the ability for customers to make quick drop-offs and pick-ups; and

Whereas, The 2 ½ hour parking in the area of the UPS Store does not allow for sufficient turn-over; and

Whereas, A proposal for 30 minute parking spaces for the UPS Store received the unanimous approval of the St. Albans Downtown Board on February 17, 2015;

Therefore, Be it resolved that the following amendments are proposed to Title 17, Chapter 5, Sub-Chapter 6:

Sub-Chapter 6. Timed Parking Zones

[other sections omitted – no proposed changes]

SECTION

5351. Designation of Zones

a. The following described streets and areas in the City of St. Albans are hereby designated and established as two and a half hour parking areas, except for any spaces otherwise designated for 30 minutes under section 5351(b):

(1) The east side of North Main Street from Fairfield Street north to the south property line of the Pomerleau Shopping Center.

(2) The west side of North and South Main Streets from the north side of Stebbins Street north to Hoyt Street with the exception of the portions described in (b) of this section as thirty minute parking zones.(Ch 5-14-07)

(3) Kingman Street on the north and south sides between Federal Street and North Main Street.

(4) Lake Street north and south sides between South Main Street and the intersection of North and South Elm Streets with said Lake Street.

(5) The east and west sides of Federal Street between the north side of Lake Street and the south side of Center Street.

(6) The east side of Catherine Street from the intersection of Lake Street south to the north driveway of the shopping plaza.

(7) Stebbins Street north and south side from South Main Street to Allen Street. (Ch 12-6-05)

(8) Bank Street on the north side between the intersection of North Main Street and Maiden Lane and on the south side of Bank Street between the intersection with North Main Street and the west side of Church Street.

(9) Congress Street on the north side between North Main Street and the intersection of Messenger Street.

(10) Center Street north side between Federal and North Main Street. (Ch 3-30-93)

(11) West side of Maiden Lane from Congress to Bank Street. (Added 1-5-99)

(12) On the east side of parking lot No. 2 from Lake Street along the west side of the building at 26 Lake Street and clearly marked as two and one-half hour parking. (Added 7-6-06)

(13) On the east side of parking lot No. 1 from Lake Street along the west side of the building at 19-27 Lake Street clearly marked as two and one-half hour parking. (Added 7-6-06)

b. The following described streets in the City of St. Albans are hereby designated and established as thirty minute parking zones.

(1) South Main Street from the intersection of Lake Street south to the first crosswalk on South Main Street (west side) from the hours of 9:00 a.m. to 6:00 p.m. Monday through Saturday. (Add 7-29-03)

(2) The two parking spaces on the west side of Federal Street immediately in front of the building at 44-46 Federal Street from the hours of 7:30 a.m. to 5:30 p.m. Monday through Saturday. (Added 04-14-2014)

(3) The two southern-most parking spaces before the mid-block crosswalk curb extension on the west side of North Main Street and near 36-38 North Main Street from the hours of 9:00 a.m. to 6:00 p.m. Monday through Saturday. (Added XX-XX-XXXX)

[other sections omitted – no proposed changes]

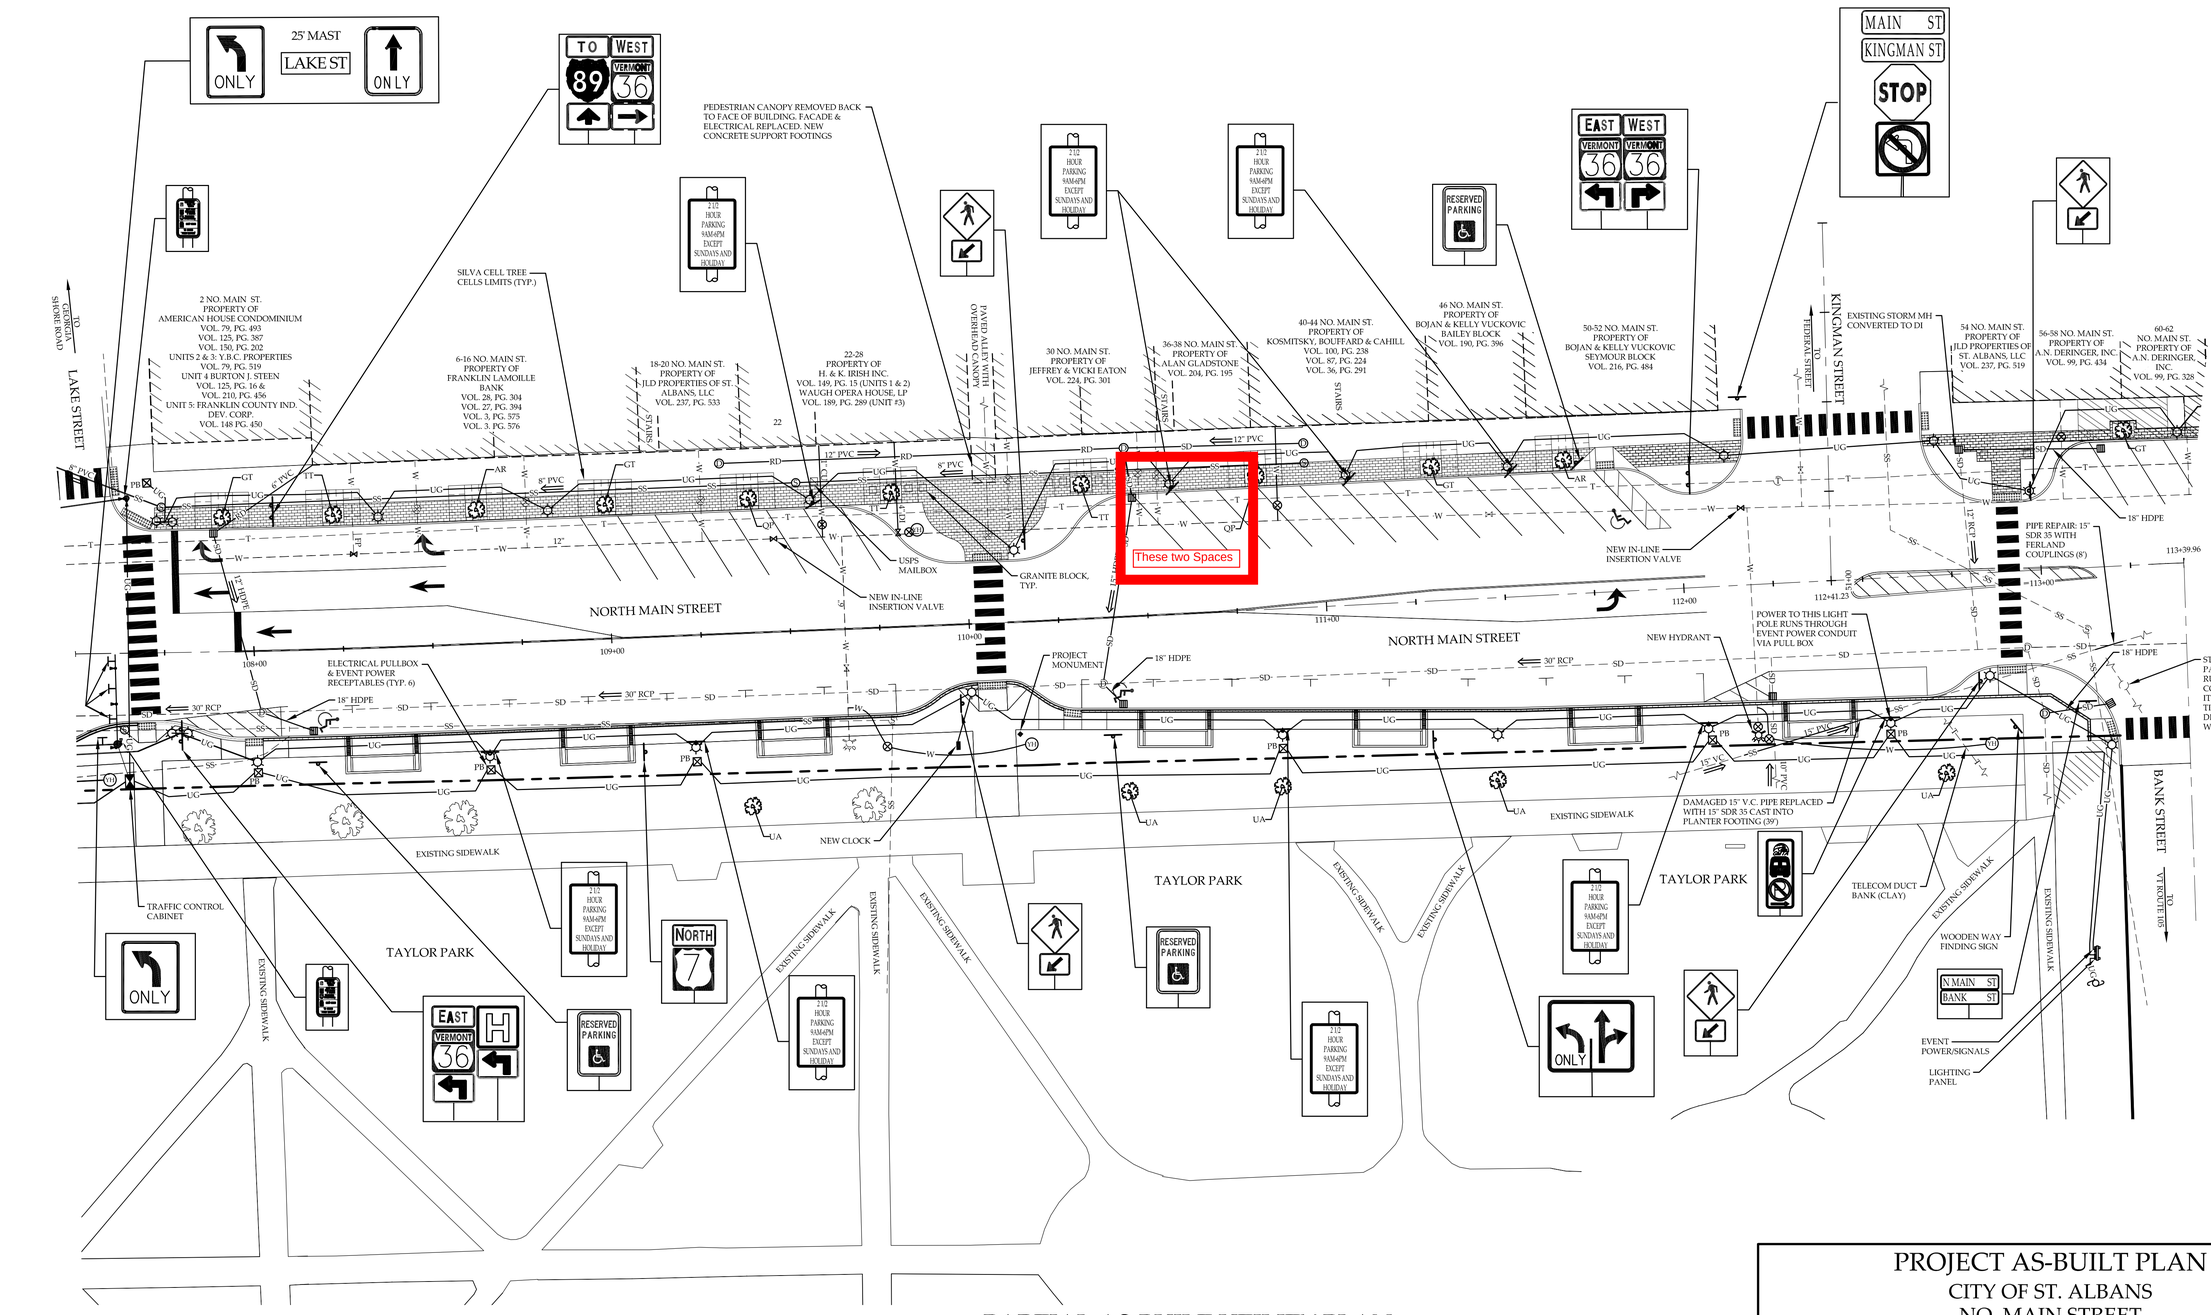

PARTIAL AS-BUILT UTILITY PLAN
NO. MAIN STREET - STATION 107+50 TO 113+39.96

1 / AB-3

SCALE: 1" = 20'

Graphic Scale

20 0 20 40 80 feet

PROJECT AS-BUILT PLAN
CITY OF ST. ALBANS
NO. MAIN STREET
ST. ALBANS, VERMONT

RUGGIANO engineering, inc.
5 LAKE STREET
ST. ALBANS, VERMONT 05478
PHONE - (802) 524-9300 FAX - (802) 524-9700

COPYRIGHT ©2014 - RUGGIANO ENGINEERING, INC.

PROJECT NO.....12058
DRAWN BY.....JGE,NRL
CHECKED BY.....LEW
SCALE.....1" = 20'
DATE.....01/23/14

SHEET NO.
AB-3
3 OF 4 SHEETS